



図面来歴

△107-2/5 完成図


DECK PLAN

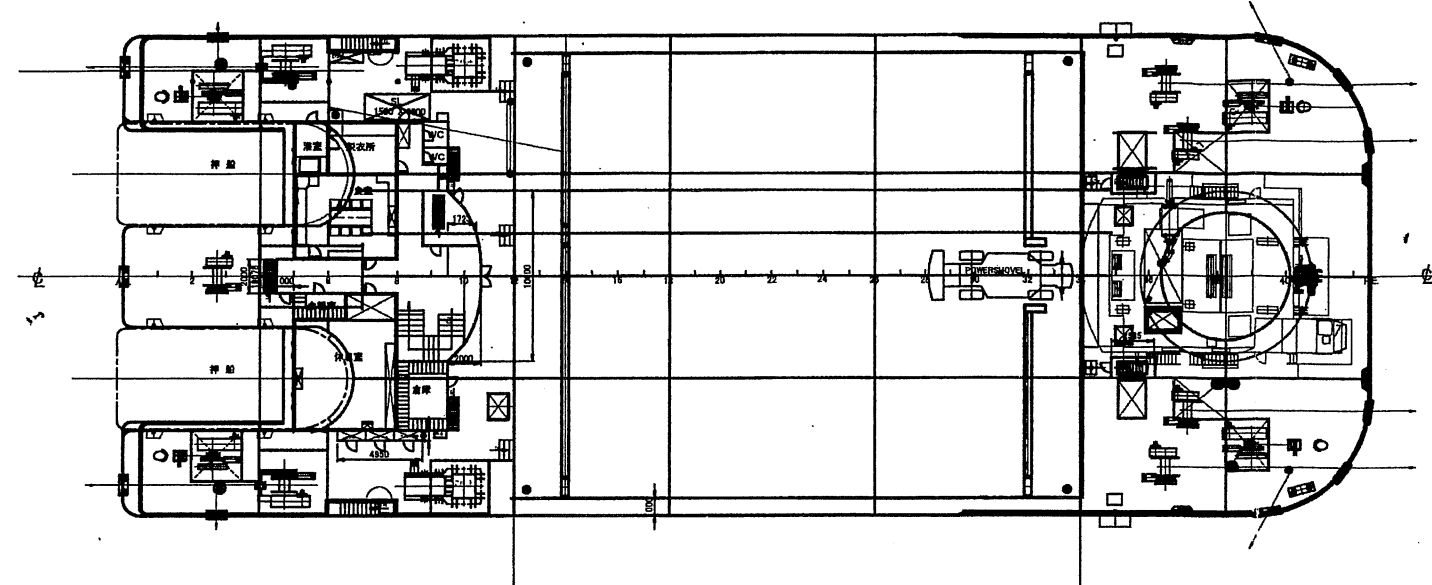



"C" DECK PLAN

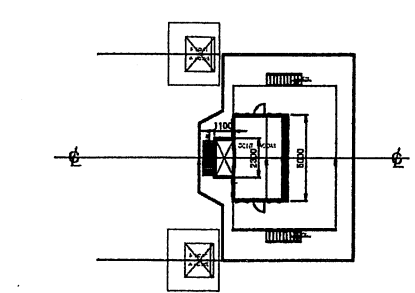


"B" DECK PLAN

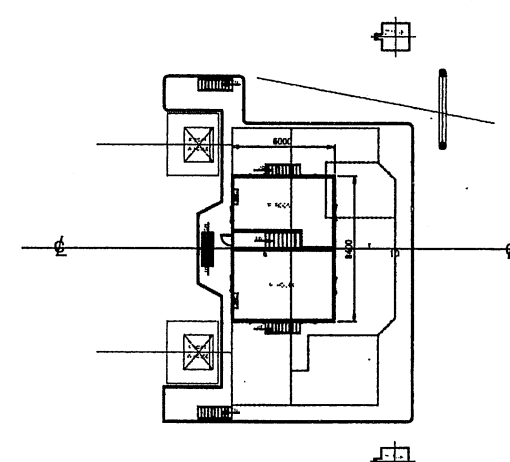

"A" DECK PLAN

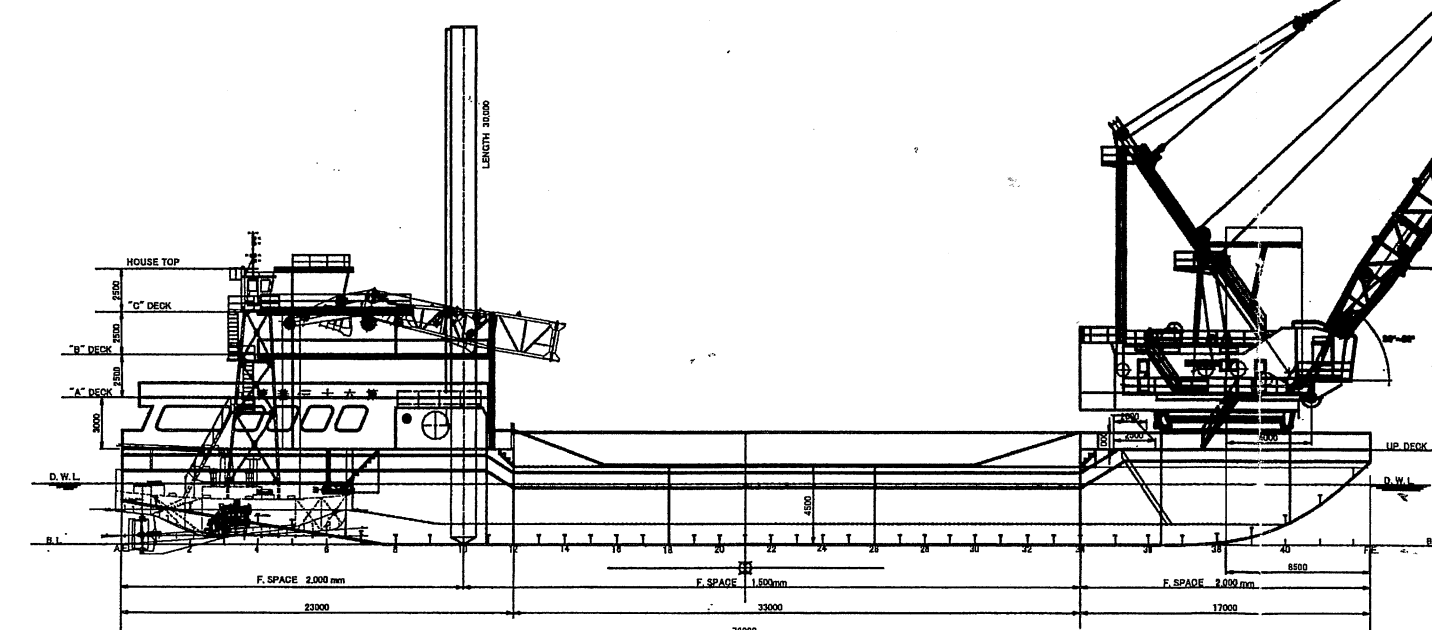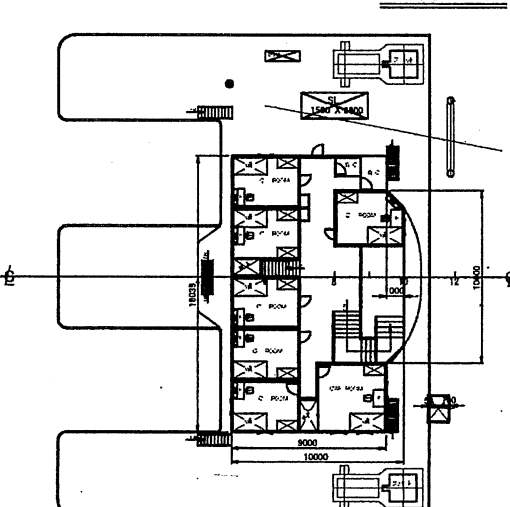

BOTTOM PLAN

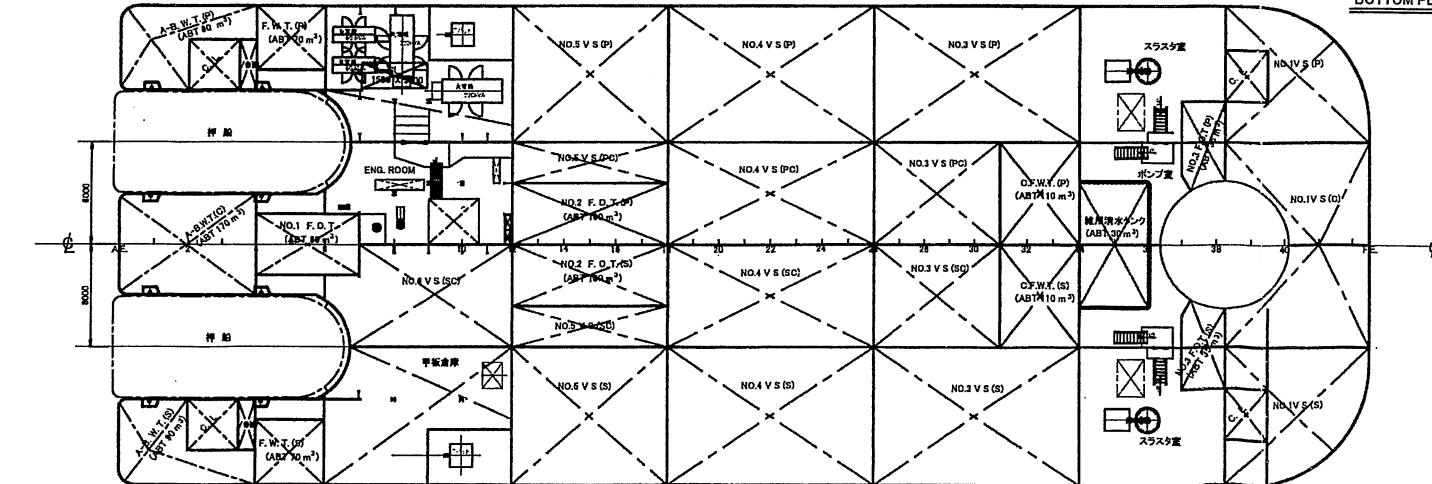

PRINCIPAL DIMENSIONS

LENGTH (O.A.)	73.00 (M)
BREADTH (MLD)	28.00 (M)
DEPTH (MLD)	4.50 (M)
DRAFT	3.50 (M)

OWNER	有限会社 宮崎丸船政(株)	NAME OF SHIP	第六十三番丸
TYPE	400 T 系全鋼船式超置積船 兼クランプ積載船	S. NO	470
APPROVED	<p>一般配置図</p>		
CHECKED			
DRAWN			
SCALE			
ORDER	DRAWING NO.	G-002-00F	REV
KUMAMOTO DOCK CO.,LTD			